



HULL CENTRELINE SECTION - PORT

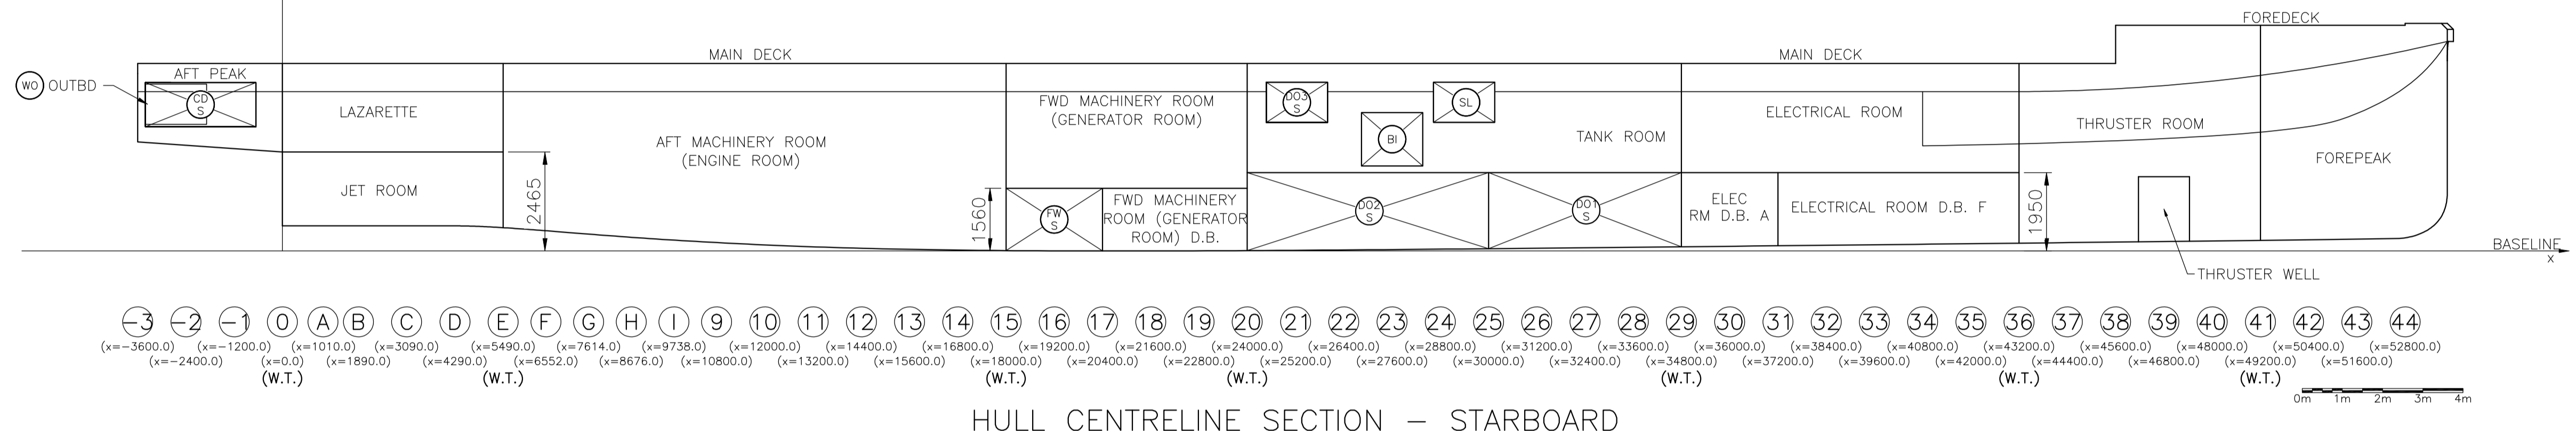

HULL CENTRELINE SECTION - STARBOARD

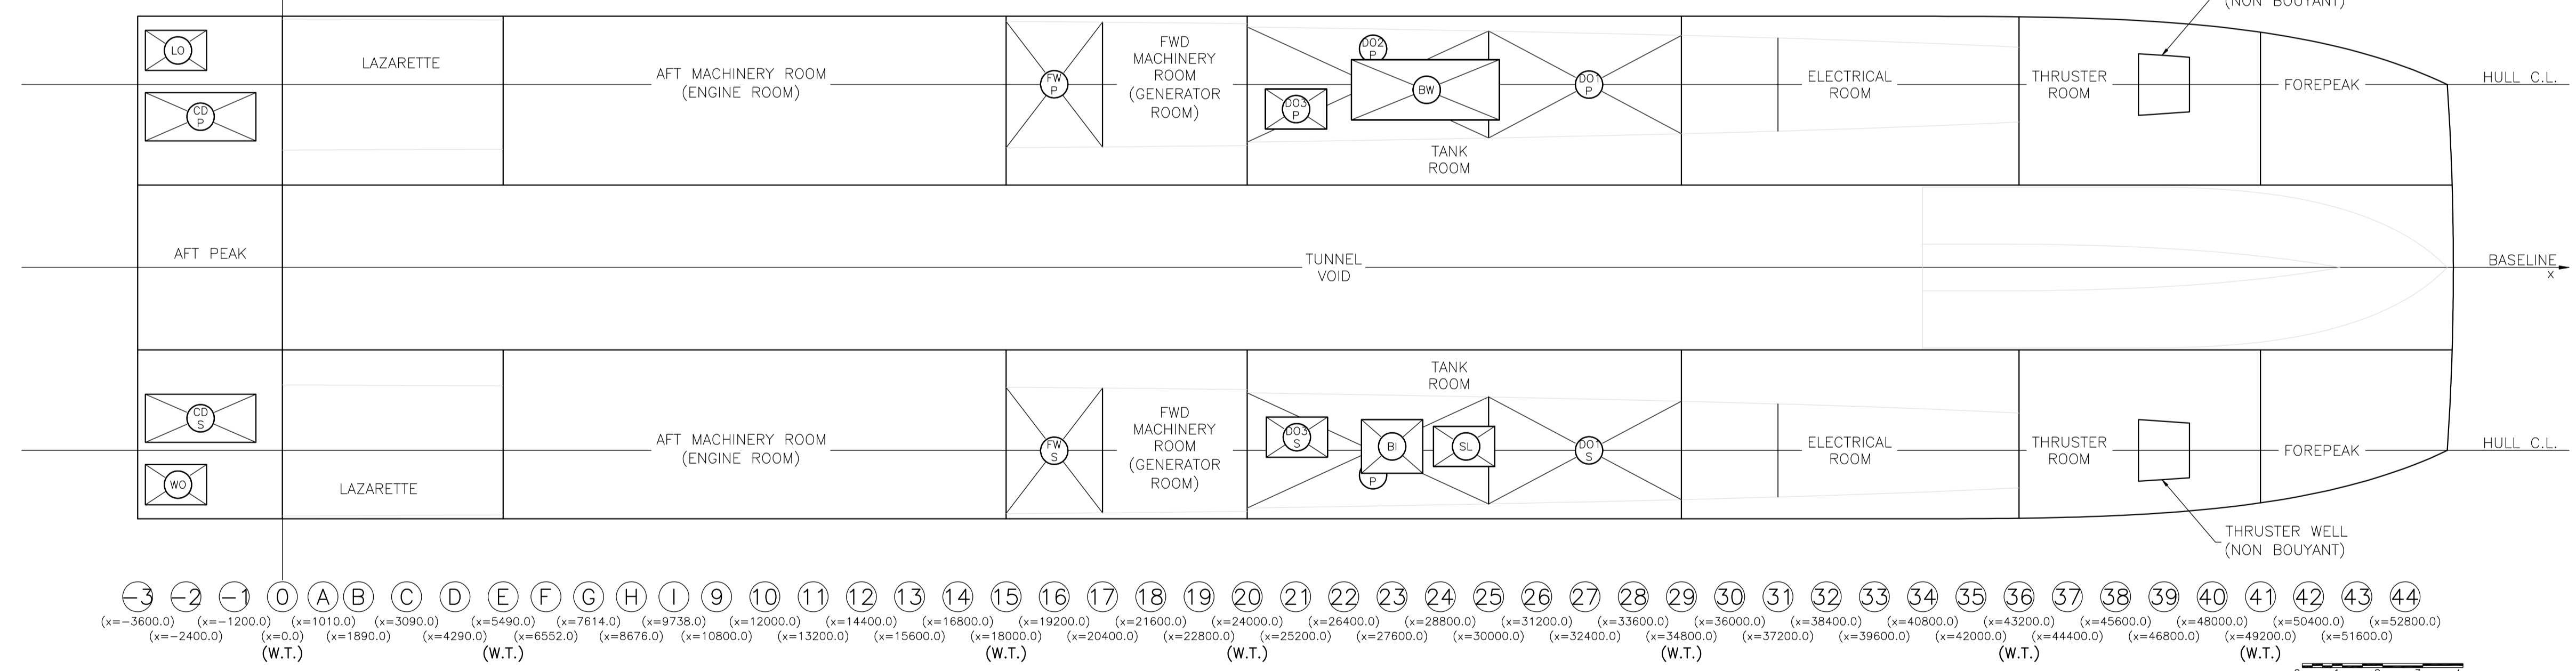

HULL AND UNDERWING PLAN

| TANK DATA |                |                     |                   |        |             |        |        |       |               |                          |                          |
|-----------|----------------|---------------------|-------------------|--------|-------------|--------|--------|-------|---------------|--------------------------|--------------------------|
| NAME      | FLUID          | S.G.                | CAPACITY          | WEIGHT | LOCATION    | LCG    | TCG    | VCG   | TYPE          | MIN TANK VENT HEIGHT (m) | MAX TANK VENT HEIGHT (m) |
|           |                | (t/m <sup>3</sup> ) | (m <sup>3</sup> ) | (t)    |             | (m)    | (m)    | (m)   |               |                          |                          |
| D01-P     | DIESEL OIL     | 0.840               | 21.314            | 17.904 | FR25 - FR29 | 32.353 | 4.550  | 1.082 | INTEGRAL      | 0.900                    | 1.000                    |
| D01-S     | DIESEL OIL     | 0.840               | 21.314            | 17.904 | FR25 - FR29 | 32.353 | -4.550 | 1.082 | INTEGRAL      | 0.900                    | 1.000                    |
| D02-P     | DIESEL OIL     | 0.840               | 29.707            | 24.954 | FR20 - FR25 | 26.951 | 4.550  | 1.057 | INTEGRAL      | 0.900                    | 1.000                    |
| D02-S     | DIESEL OIL     | 0.840               | 29.707            | 24.954 | FR20 - FR25 | 26.951 | -4.550 | 1.057 | INTEGRAL      | 0.900                    | 1.000                    |
| D03-P     | DIESEL OIL DAY | 0.840               | 1.000             | 0.840  | FR20 - FR22 | 25.212 | 3.940  | 3.708 | FREE STANDING | 0.900                    | 1.000                    |
| D03-S     | DIESEL OIL DAY | 0.840               | 1.000             | 0.840  | FR20 - FR22 | 25.232 | -4.220 | 3.708 | FREE STANDING | 0.900                    | 1.000                    |
| FW-P      | FRESH WATER    | 1.000               | 10.184            | 10.184 | FR15 - FR17 | 19.199 | 4.550  | 0.852 | INTEGRAL      | 0.900                    | 1.000                    |
| FW-S      | FRESH WATER    | 1.000               | 10.184            | 10.184 | FR15 - FR17 | 19.199 | -4.550 | 0.852 | INTEGRAL      | 0.900                    | 1.000                    |
| CD-P      | DISPERSANT     | 1.000               | 2.500             | 2.500  | FR-3 - FR-1 | -2.035 | 3.750  | 3.65  | FREE STANDING | 0.900                    | 1.000                    |
| CD-S      | DISPERSANT     | 1.000               | 2.500             | 2.500  | FR-3 - FR-1 | -2.035 | -3.750 | 3.65  | FREE STANDING | 0.900                    | 1.000                    |
| LO        | LUBE OIL       | 0.920               | 1.000             | 0.920  | FR-3 - FR-1 | -2.647 | 5.400  | 3.700 | FREE STANDING | 0.900                    | 1.000                    |
| BW        | BLACK WATER    | 1.025               | 6.000             | 6.150  | FR23 - FR27 | 28.430 | 4.420  | 2.913 | FREE STANDING | 0.900                    | 1.000                    |
| BI        | BILGE WATER    | 1.025               | 2.000             | 2.05   | FR21 - FR23 | 27.602 | -4.450 | 2.789 | FREE STANDING | 0.900                    | 1.000                    |
| SL        | SLUDGE         | 0.913               | 1.000             | 0.913  | FR24 - FR25 | 29.392 | -4.450 | 3.708 | FREE STANDING | 0.900                    | 1.000                    |
| WO        | WASTE OIL      | 0.913               | 1.000             | 0.913  | FR-3 - FR-1 | -2.544 | -5.323 | 3.660 | FREE STANDING | 0.900                    | 1.000                    |

- NOTES:**
1. VERTICAL DATUM FOR THIS DRAWING IS THE CONSTRUCTION MOULDED BASELINE
  2. USK 8mm BELOW CONSTRUCTION MOULDED BASELINE
  3. TANK VENT HEIGHT TAKEN FROM MAIN DECK
  4. TEST PRESSURE IS HYDROSTATIC PRESSURE TO VENT

AUSTAL No.  
409-100-009  
SFI No.  
102020-004

**Incat Crowther**  
PO BOX 179 Terrey Hills NSW 2084 Australia  
p. +61 2 9450 0447 f. +61 2 9450 0494  
info@incatcrowther.com  
www.incatcrowther.com

**DESIGN**  
57m CATAMARAN CREWBOAT

**DESCRIPTION**  
TANKAGE AND CAPACITIES PLAN

**DESIGN No.** IC13092  
**SHEET No.** D-124

**DRAWN** C.F. **DATE** 16JUL15 **CHECKED** H.D. J.S. P.O. **SCALE** 1:100

**DO NOT SCALE**  
DIMENSIONS IN MILLIMETRES UNLESS NOTED

PROPRIETARY INFORMATION - COPYRIGHT All Rights Reserved  
In compiling this document, Incat Crowther relies upon information supplied by a number of external sources. The document is supplied on the basis that while Incat Crowther believes all the information in it will be correct at the time of publication, it does not warrant its accuracy or completeness and to the full extent allowed by law excludes liability in contract, tort or otherwise, for any loss or damage sustained by the reader, or by any other person or body corporate arising from or in connection with the supply or use of the whole or any part of the information in this document. Incat Crowther Pty. Ltd. ACN 104 658 791  
One boat only from this set of plans

| X   | AS BUILT | JCO   | 20OCT16 |
|-----|----------|-------|---------|
| NO. | REVISION | DRAWN | DATE    |
|     |          |       |         |

