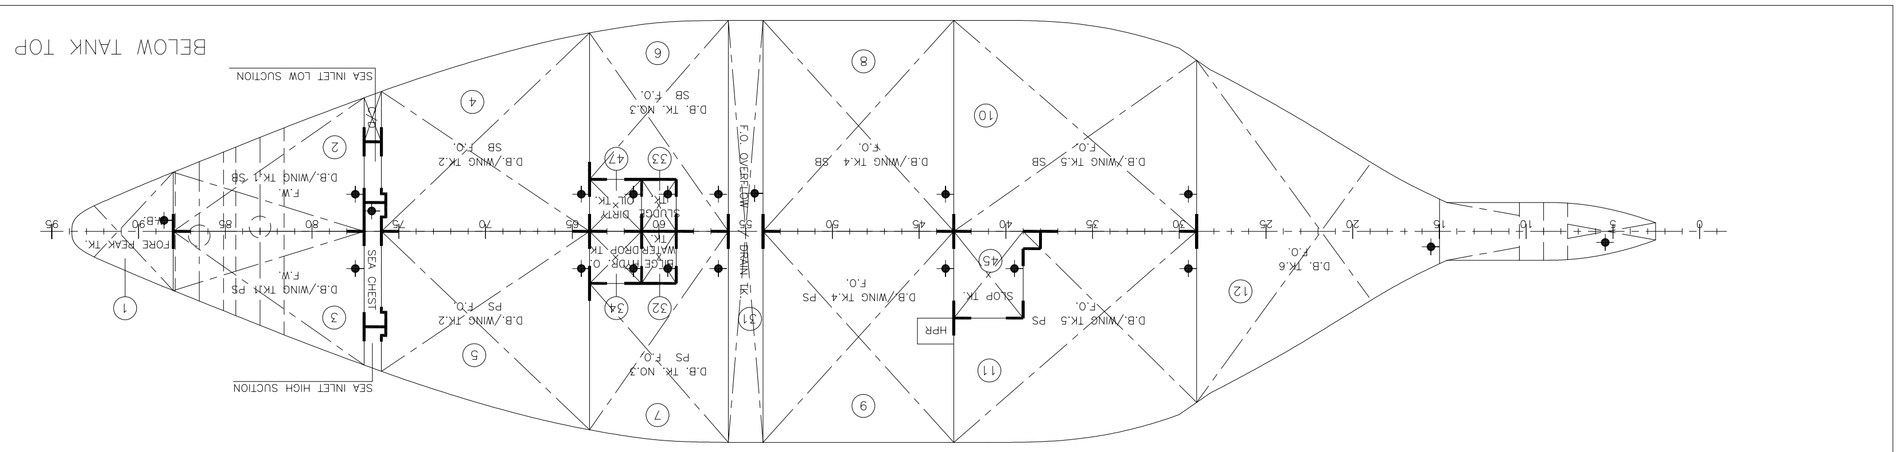

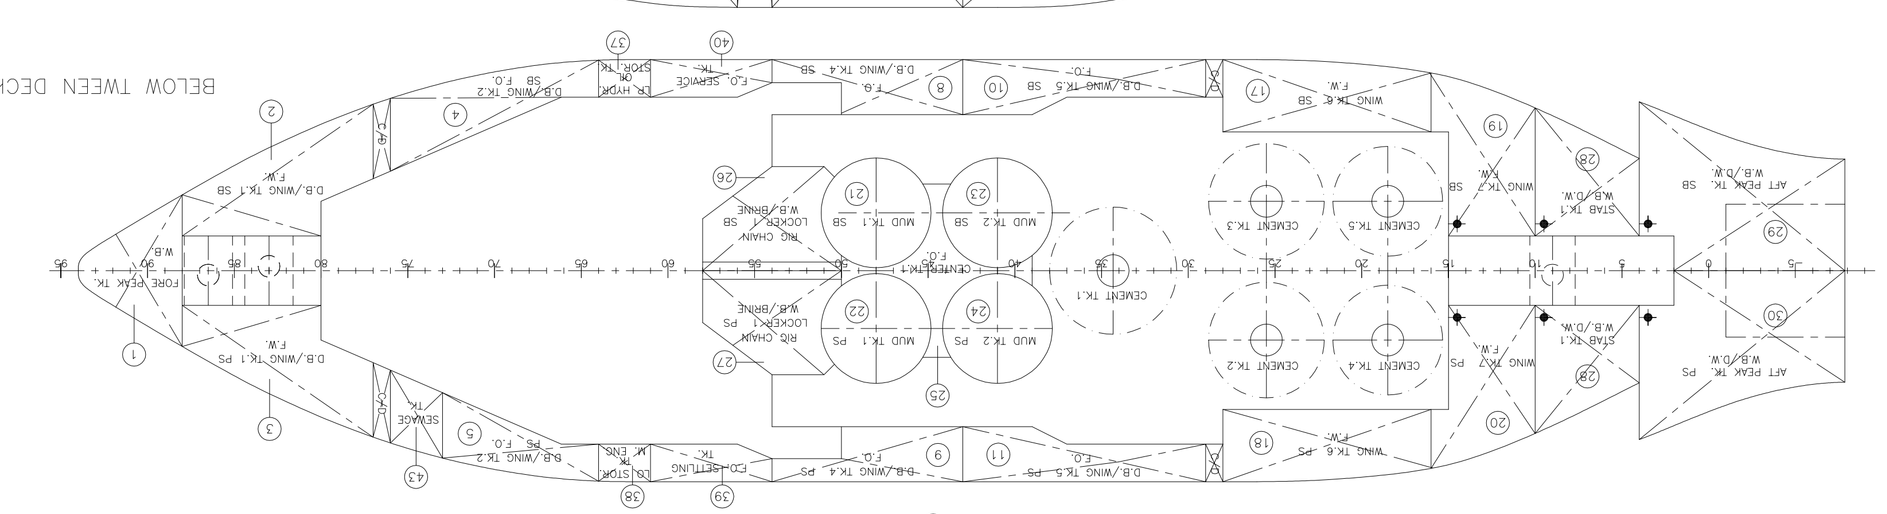

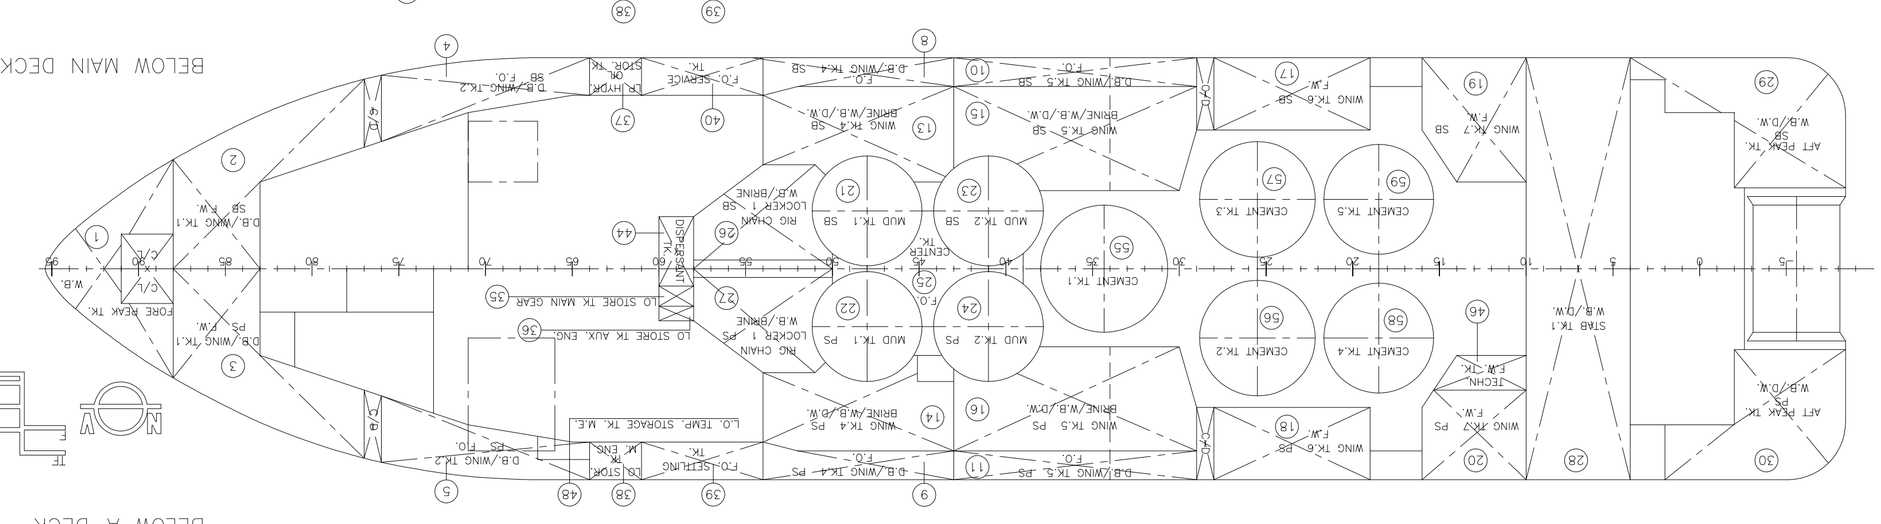

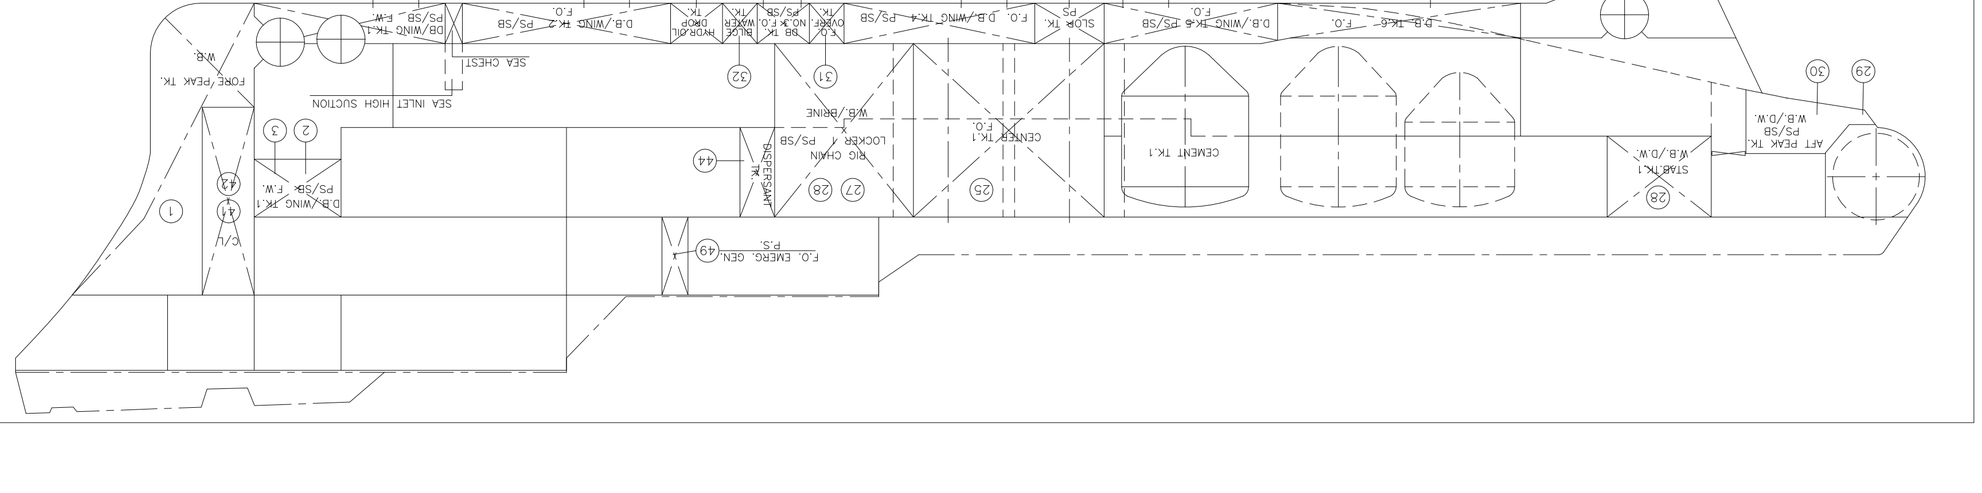

NO.	ALTERATIONS	DATE	APPR.
D	DRAIN PLUGS ADDED	08.07.96	BJH
E	DIFF. MODIFICATIONS	16.08.96	KVM
F	DIFF. MODIFICATIONS	28.08.96	KVM
G	DIFF. MODIFICATIONS	09.10.96	EB
H	VOLUMES CORRECTED, AS BUILT 251, ADDED TK.49	07.04.97	BOL
I	CEMENT TANKS ADDED AND TABLE MODIFIED	13.05.97	POL

Vessel No.:	251	252	253
TITLE	Pacific Buccaneer	254	255	256
	Tank Capacity Plan	SCALE 1:150	DRAWN DR	SI
			CHECKED CH	SIGN
			APPROVED	

ULSTEIN INDUSTRIER AS
Dept. Ulstein International – Design
Ulsteinvegen 165 N-6065 Ulsteinvik, Norway
Telephone +47 70 01 60 00 Telefax +47 70 01 60 13.
Authority number NO 934654510

PROJECT NO.	DRAWING NO.	REV.
BUC-CAP-01	P-D-3387	1

251 NB 101-818

U:\SHIPDB\BUC\TK-CAP 1:150

| TANK NO | AIR PIPE HEIGHTS ABOVE B. | TANK | CONTENTS | DENS | CAPACITY IN m³ | TOTAL CAPACITY IN TONNES | | |