FRAME 0

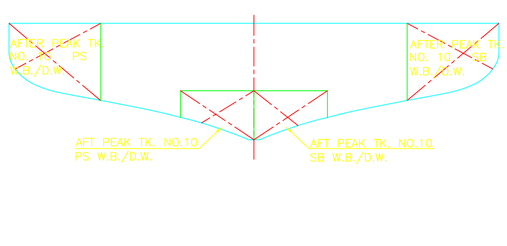

FRAME 0

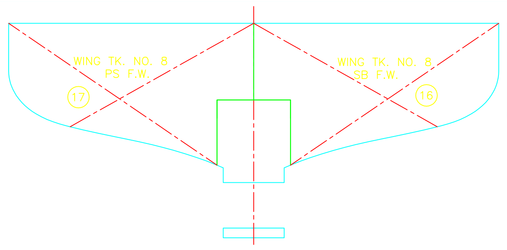

FRAME 7

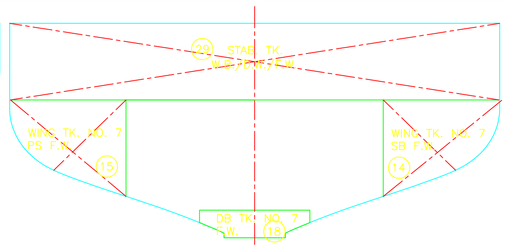

FRAME 18

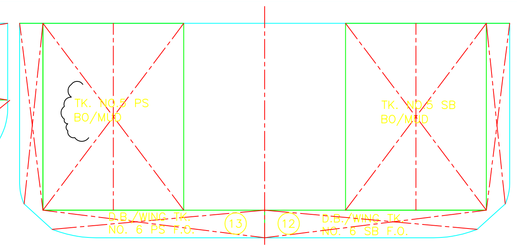

FRAME 36

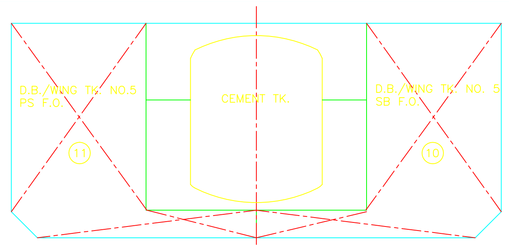

FRAME A

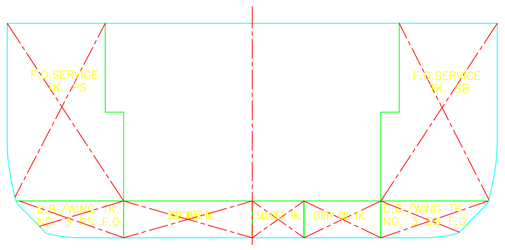

FRAME 64

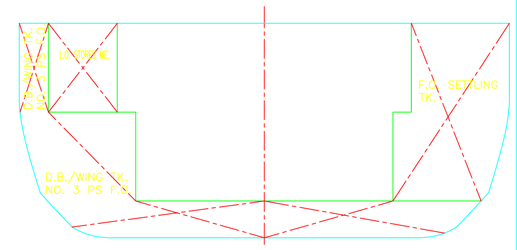

FRAME 69

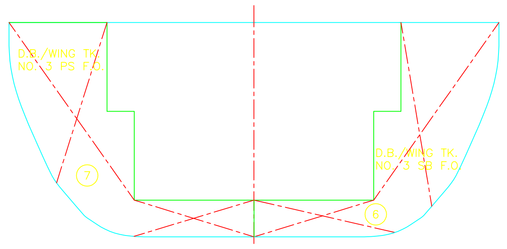

FRAME 75

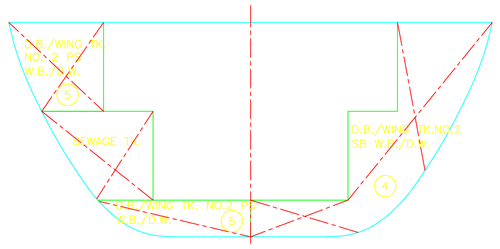

FRAME 81

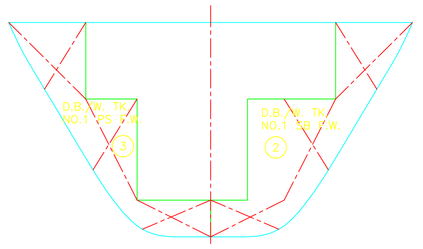

FRAME 88

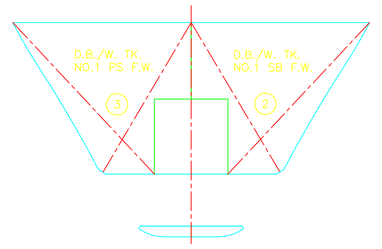

FRAME 91

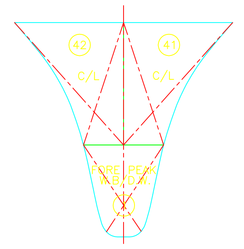

FRAME 98

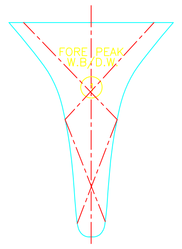

FRAME 100

C. L. PROFILE

BELOW MAIN DECK

BELOW TWEEN DECK

BELOW TANK TOP

TANK NO.	AIR PIPE HEIGHTS AB. BL.	TANK ID.	FRAME MIN.	FRAME MAX.	CONTENTS	DENSITY	VOLUME (M3)	WEIGHT(TONNES) / DENSITY (T/M3) WB 1.025	DV 1.000	FW 1.000	FO 0.900	BO 0.830	BRI 2.500	MUD 2.500	CEM 2.400	CENTER OF GRAVITY (M) LCG (AP)	VCG (BL)	TCG (CL)	IT (M4)
01		FOREPEAK TK	96	103	WB/DW	1.025	32.7	33.6	32.7							65.167	3.716	-0.000	19
02		DB/WING TK 1 SB	84	96	FW	1.000	120.5			120.5						59.288	4.197	2.808	106
03		DB/WING TK 1 PS	84	96	FW	1.000	107.7			107.7						59.437	4.353	-2.937	103
04		DB/WING TK 2 SB	78	84	WB/DW	1.025	6.4 1	65.7	64.1							54.212	3.408	4.574	26
05		DB/WING TK 2 PS	78	84	WB/DW	1.025	47.5	48.7	47.5							54.432	3.689	-4.535	26
06		DB/WING TK 3 SB	61	78	FO	0.900	134.8				121.3					49.027	2.628	4.970	207
07		DB/WING TK 3 PS	61	78	FO	0.900	153.4				138.1					48.619	2.694	-5.208	197
08		DB/WING TK 4 SB	48	61	FO	0.900	144.7				130.2					36.969	2.702	5.918	284
09		DB/WING TK 4 PS	48	61	FO	0.900	144.6				130.2					36.968	2.702	-5.918	284
10		DB/WING TK 5 SB	42	48	FO	0.900	101.9				91.7					28.891	2.391	5.519	293
11		DB/WING TK 5 PS	42	48	FO	0.900	101.9				91.7					28.891	2.391	-5.519	293
12		DB/WING TK 6 SB	28	42	FO	0.900	143.5				129.2					21.121	2.506	5.453	302
13		DB/WING TK 6 PS	28	42	FO	0.900	143.5				129.2					21.121	2.506	-5.453	302
14		WING TK 7 SB	14	27	FW	1.000	74.5			74.5						12.755	3.022	5.907	32
15		WING TK 7 PS	14	27	FW	1.000	74.4			74.4						12.734	3.024	-5.904	33
16		WING TK 8 SB	4	14	FW	1.000	172.7			172.7						5.599	5.031	3.950	256
17		WING TK 8 PS	4	14	FW	1.000	172.7			172.7						5.599	5.031	-3.950	256
18		DB TK 7	14	27	FW	1.000	20.4			20.4						12.765	8.460	-0.030	23
19		TK 1 SB	56	64	MUD/BRI/WB/DW/FO	2.500	87.7	89.8	87.7		78.9		219.1	219.1		41.570	4.147	5.154	22
20		TK 1 PS	56	64	MUD/BRI/WB/DW/FO	2.500	87.7	89.8	87.7		78.9		219.1	219.1		41.570	4.147	-5.154	22
21		TK 2 SB	48	56	MUD/BRI/WB/DW/FO	2.500	84.6	86.7	84.6		76.1		211.4	211.4		36.650	3.950	5.251	13
22		TK 2 PS	48	56	MUD/BRI/WB/DW/FO	2.500	84.6	86.7	84.6		76.1		211.4	211.4		36.650	3.950	-5.251	13
23		TK 3 SB	47	48	MUD/FO	2.500	84.6				76.1			211.4		31.650	3.950	5.251	13
24		TK 3 PS	47	48	MUD/FO	2.500	84.6				76.1			211.4		31.650	3.950	-5.251	13
25		TK 4 SB	40	47	MUD/FO	2.500	99.8				89.8			249.4		26.650	3.950	4.940	22
26		TK 4 PS	40	47	MUD/FO	2.500	99.8				89.8			249.4		26.650	3.950	-4.940	22
27		TK 5 SB	32	40	BO/MUD/FO	2.500	99.8				89.8	82.8		249.4		21.650	3.950	4.940	22
28		TK 5 PS	32	40	BO/MUD/FO	2.500	99.8				89.8	82.8		249.4		21.650	3.950	-4.940	22
29		STAB TK 1	14	20	WB/DW/FW	1.025	139.7	143.2	139.7	139.7						10.200	5.750	0.000	1229
30		FD SERVICE TK SB	61	66	FO	0.900	39.1				35.2					44.075	4.020	6.554	9
31		FD SERVICE TK PS	61	66	FO	0.900	39.1				35.2					44.075	4.020	-6.554	9
32		LO STORES TK MAIN ENG	66	69	LO	0.924	11.4									46.100	5.550	-5.925	2
33		LO STORES TK AUX ENG	69	70	LO	0.924	3.8									47.300	5.550	-5.925	1
34		LO STORES TK THR	70	71	LO	0.924	3.8									47.900	5.550	-5.925	1
35		HYD. OIL SERVO TK	71	72	LO	0.924	3.8									48.500	5.550	-5.925	1
36		LP HYDR OIL STORES TK	72	73	HO	0.924	3.8									49.100	5.550	-5.925	1
37		DIRTY OIL TK	63	66	MIS	1.000	3.8									44.309	0.476	3.129	2
38		BILGE WATER TK	62	66	MIS	1.000	9.3									44.055	0.511	-2.045	15
39		SLUDGE TK	62	66	MIS	1.000	4.4									44.053	0.567	0.845	1
40		SAVE ALL TK	3	7	MIS	1.000	2.5									2.977	0.762	-0.000	0
41		CHAIN LOCKER SB	96	99	CHA	1.025	17.2									64.028	5.317	1.309	8
42		CHAIN LOCKER PS	96	99	CHA	1.025	17.2									64.028	5.317	-1.309	8
43		SEWAGE TK	78	82	MIS	1.000	18.8									53.585	2.806	-4.629	10
44		CEMENT TK 1	52	59	CEM	2.400	64.8								155.5	38.838	3.675	0.000	17
45		CEMENT TK 2	G	51	CEM	2.400	47.1								113.0	34.275	3.675	0.000	17
46		CEMENT TK 3	45	47	CEM	2.400	64.8								155.5	29.144	3.675	-0.000	17
47		CEMENT TK 4	37	43	CEM	2.400	64.8								155.5	24.150	3.675	-0.000	17
48		CEMENT TK 5	28	36	CEM	2.400	64.8								155.5	19.200	3.675	0.000	17
49		FD DRAIN TK	66	67	MIS	1.000	1.2									45.500	0.600	-0.845	0
50		FD OVERFLOW	58	63	MIS	1.000	18.6									41.682	8.447	0.174	131
51		TOP WING TK 7 SB	20	27	WB/DW	1.025	50.9	52.2	50.9							14.100	5.750	5.500	44
52		TOP WING TK 7 PS	20	27	WB/DW	1.025	50.9	52.2	50.9							14.100	5.750	-5.500	44
53		FD SETTLING TK	66	69	FD	0.900	34.2					30.8				46.095	4.046	6.182	8
54		AFT PEAK TK SB	-6	4	WB/DW	1.025	65.8	67.5	65.8							-1.381	5.498	3.622	130
55		AFT PEAK TK PS	-6	4	WB/DW	1.025	65.8	67.5	65.8							-1.381	5.498	-3.622	130
56		DISP TK	69	71	MIS	1.000	10.8									47.600	5.552	6.398	3
57		LO STORES GEAR OIL	31	33	LO	0.924	3.6									19.011	5.750	5.124	0
58		LO STORES STERN TUBE	31	33	LO	0.924	3.6									19.011	5.750	-5.124	0
59		CD W27	27	28	CD	1.000	20.2									16.501	2.186	0.000	175
60		CD BELOW FWD TUNNEL	90	96	CD	1.000	6.6									61.243	0.477	0.000	9
61		CD BELOW AFT TUNNEL	7	14	CD	1.000	5.0												
		TOTAL WEIGHTS						883.6	862.0	882.6	1884.2	165.6	861.0	2281.6	735.1				
		TOTAL VOLUMES						862.0	862.0	882.6	2093.6	199.6	344.6	912.6	306.3				

Rev.	Date	Reason for issue	Made by	Chkd by	Dept. appr.	Client appr.
I	14.08.07	REVISED DRAWING ACCORDING TO OWNER'S COMMENTS	PM (LotH)			
H	02.08.07	REVISED DRAWING ACCORDING TO OWNER'S COMMENTS	PM (LotH)			
G	02.10.06	REVISED DRAWING ACCORDING TO AS BUILT CONDITION	PM (LotH)			
F	13.07.06	MUD TK.1 P.S. CONVERTED.	ØA			
E	23.06.06	CEMENT TK 2 (TK:45) REMOVED	ØA			
D	24.03.06	CORRECTED ACC. YARD COMMENTS	ØA			
C	26.10.05	CORRECTED ACC. OWNERS COMMENTS	ØA			
B	06.10.05	CORRECTED ACC. OWNERS COMMENTS	ØA			
A	24.08.05	CORRECTED ACC. OWNERS COMMENTS	ØA	TT		
0	13.05.05	FIRST ISSUE	LB/ØA			

CONTRACT: PAN-UNITED MARINE SWIRE PACIFIC OFFSHORE

YARD: 167 168

TITLE: TANK PLAN

PRINT RECORD

Sign/Check Note	A	A	C	C	C	C	C	C	C
Rev. for Check	3	3	12	12	12	12	12	12	12
DATE	1	2	3	4	5	6	7	8	9
REVISION	0	A	B	C	D	E	F	G	H
QA/CC	2	2	1	1	1	1	1	1	1
CLASS	–	–	–	–	–	–	–	–	–
CC	1	1	1	1	1	1	1	1	1
COM. CSD	–	–	1	1	1	1	1	1	1
QC	–	–	1	1	1	1	1	1	1
DISTRIBUTION	–	–	8	8	8	8	8	8	8

Rolls-Royce Marine AS dept. Ship Technology - Offshore
Ulsnesveien 15, PO Box 1020
NO-6001 Ålesund, NORWAY
Tel.:+47 70 01 40 00
Fax:+47 70 01 40 10
E-mail:ship.technology@rolls-royce.com
Enterprise NO 980 371 379

UT-Design™

The drawing is the property of Rolls-Royce Marine AS, dept. Ship Technology - Offshore, and must not be copied in any form, disclosed to a third party or used for any purpose other than that for which it was originally supplied. The recipient undertakes to prevent any unauthorised use. In the event of infringement of these undertakings, Rolls-Royce Marine AS reserves the right to claim damages.

1:100 | A0 | 047241 · 101 · 020 | I

Scale | Format | PROJECT NO. | Sect. no. | Revision